




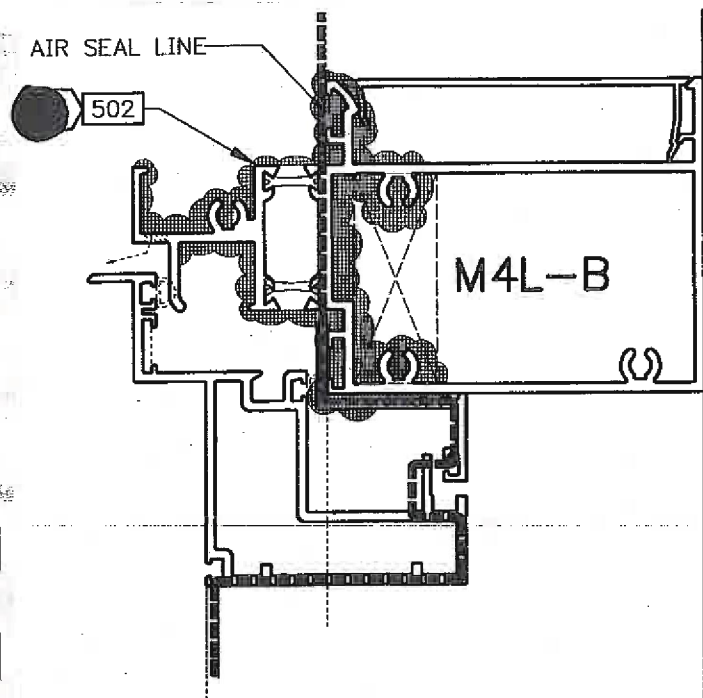


JOINERY SEALANT DETAIL
1=2

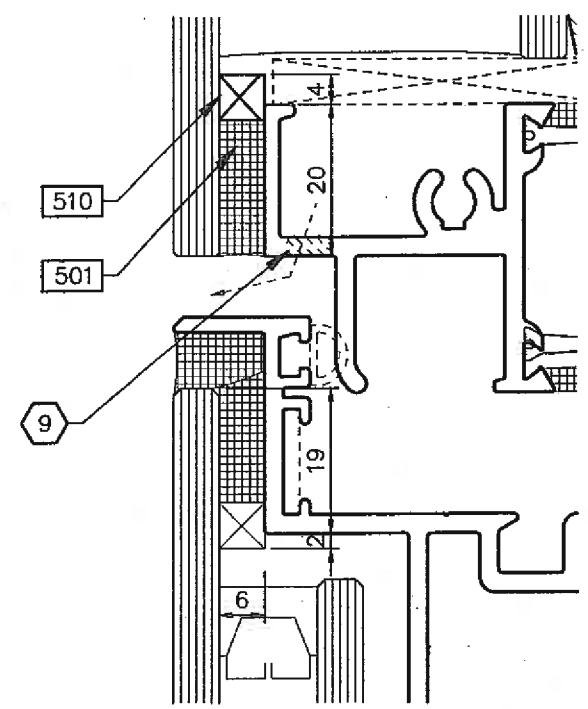

GLAZING DETAIL 2
1=1

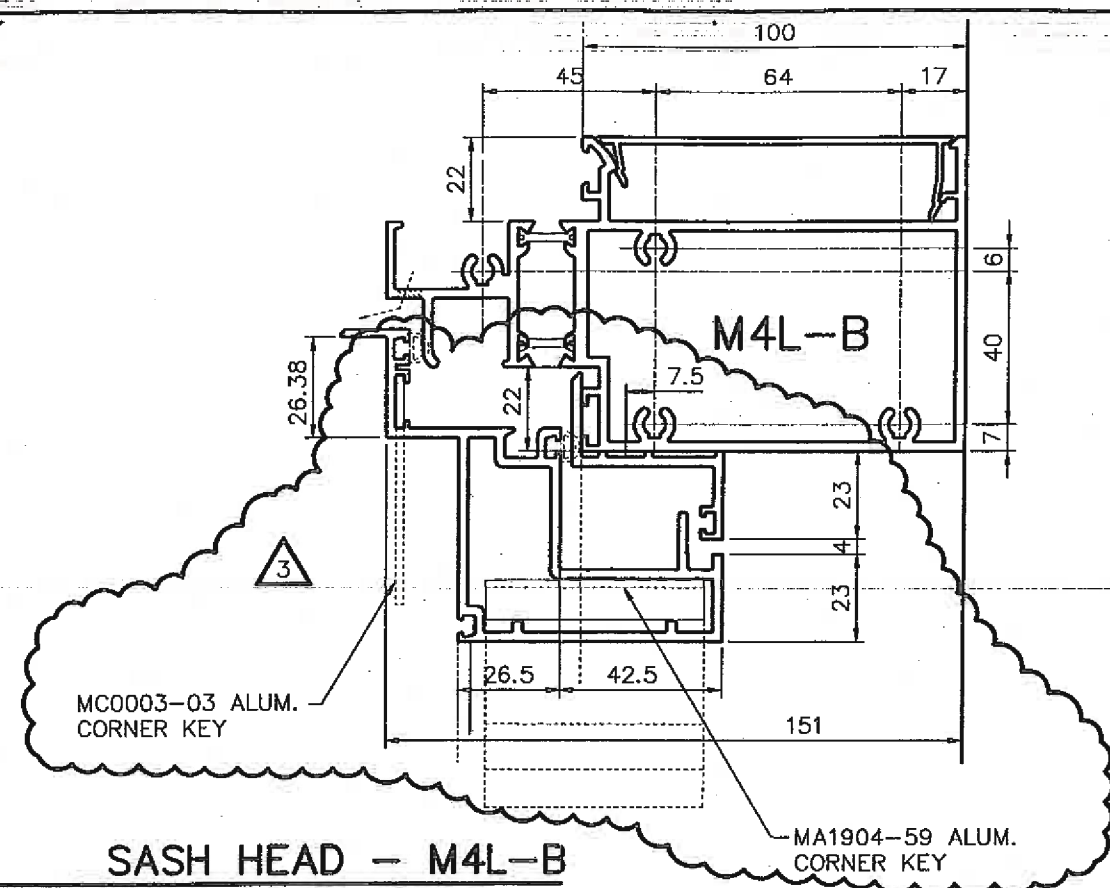


SASH HEAD - M4L-B
1=2
PREP DIMENSIONS

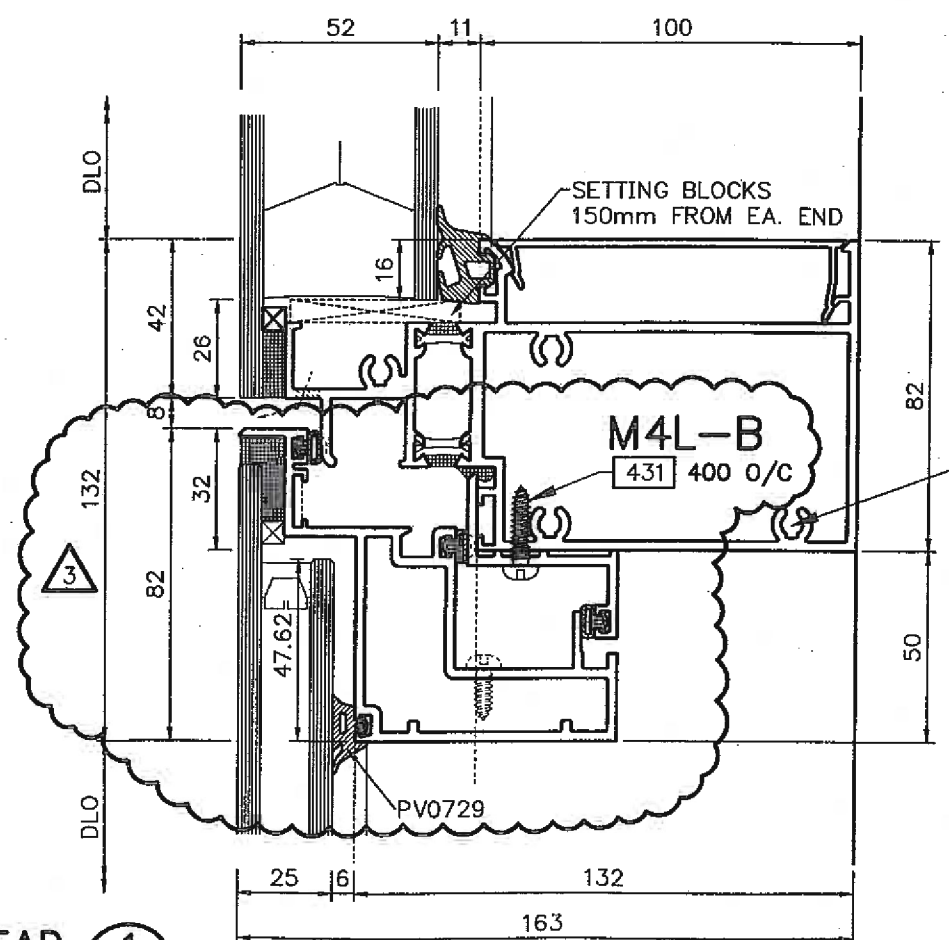

VENT HEAD 1
1=2
(ARCH. REF. 3/A-711)

KEYNOTES:

- 1 SCREWS SPACED AT 100mm O/C
- 2 SCREWS SPACED AT 200mm O/C
- 3 SCREWS SPACED AT 300mm O/C
- 4 SCREW AT 1/3 POINTS
- 5 (2) NOMINAL 10mmØ HOLES AT 1/4 POINTS FOR DRAINAGE AND PRESSURE EQUALIZATION
- 6 MACHINE SLOT 20mm LONG FOR WEEP/PRESSURE EQUALIZATION (3 Per)
- 7 INSTALL PLUG AT EACH END OF RAIL. APPLY SEALANT TO SURFACES AS INDICATED BEFORE ASSEMBLING.
- 8 2 CLIPS PER DESICCANT CHAMBER, 1 SCREW PER CLIP.
- 9 3-6mmØ HOLES 75mm FROM EA. END AND 1 AT CENTERLINE

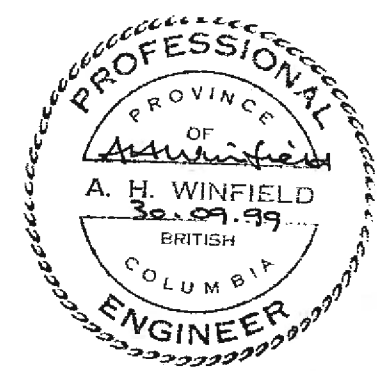

WALL CENTRE PHASE II Vancouver, British Columbia		OPERABLE VENT HEAD DETAIL	
av Drawn by 99/04/21 Date	AS NOTED Scale	ck'd by 99/04/30 Issue date	SEP 30 1999
3 vent dies revised / corner key av 99/09/29	2 vent dies revised / dims rev ck 99/06/10	1 add notes, details/profile dims av 99/04/28	Rev.
J204		2602	3
Part No./Job No.		Drawing No.	Rev.